

Park District of Highland Park

2022 Moraine Park Path Improvements

ADDENDUM #2

March 3, 2022

ISSUED BY:

Jeff Smith

Park District of Highland Park

636 Ridge Road

Highland Park, IL 60035

NOTICE TO ALL BIDDERS:

The attention of all Bidders is called to this Addendum. This Addendum to the Bid documents is issued to modify, explain or correct the original documents. It is hereby included in and made part of the Bid Contract Documents and Project Manual, whether or not attached to.

All requirements of the original Project Specifications, Scope of Work and Drawings shall remain in force except as amended by this document.

Item #1 – Response to request for clarifications received:

Sheet 5 of 6 - Stone Fill or Path Rubble Backfill Behind Existing Wall to EL. 687. We believe this is a typo and should be to EL. 587. Please Confirm.

This is a typo and should read 587.

Sheet 5 of 6 – Proposed 6” to 12” Berm is to be constructed from onsite materials – no import of material is required. Please confirm.

That is correct.

Please confirm which line item includes the erosion control measures to be installed: Tree Protection, Silt Fence Install, and Silt Worm Install.

Additional line item added to Bid Form. Revised Bid Form attached.

Please provide cover dimension for the 6” Directionally Bored Storm sewer in the bluff.

Minimum depth should be three feet.

Sheet S2.1 – Detail 1 – Mention of Prefabricated Panels under the 2X10 Rim Boards call out, Please advise on these and their incorporation into the work.

See revised Sheet S2.1 attached.

Sheet S2.1 – Detail 3 – Please advise on any finishing coatings for the Steel 8X18 piles. Or are they left bare?

See revised Sheet S2.1 attached.

Sheet S2.1 – Detail 2 – Please advise on the gauge of the STL Wire Mesh for the railing.

See revised Sheet S2.1 attached.

Item #2 – Bid Opening Date Change

The Bid Opening is rescheduled for Tuesday, March 15 at 2:00pm.

Item #3 – Construction Schedule Change

Project completion date extended to September 30, 2022.

Park District of Highland Park
2022 Moraine Park Path Improvements

BID FORM
 (Page 1 of 3)

TO: Park District of Highland Park
 636 Ridge Road
 Highland Park, IL 60035

FROM: _____
 Company

 Street Address

 City, State, Zip

 Phone

FOR: 2022 Moraine Park Path Improvements

BASE BID:

Item No.	Item	Quantity	Unit	Unit Cost	Total
1	GENERAL CONDITIONS				
1.1	Mobilization	1	EA	LS	\$
1.2	Stabilized construction entrance including stairs & bridge protection and restoration & removal upon completion	1	EA	LS	\$
1.3	Temporary construction fencing	225	LF	\$	\$
1.4	Tree protection fencing, silt fence and silt worm	1	EA	LS	
				Item 1 Total	\$
2	BOARDWALK IMPROVEMENTS				
2.1	Remove/replace repair stone path at east end	25	SF	\$	\$
2.2	Pile 3 lagging bulkhead	1	EA	\$	\$
2.3	Remove existing wood platform adjacent to bridge	72	SF	\$	\$
2.4	Removal of existing stone walls to be crushed & reused for fill material	404	LF	\$	\$
2.5	Removal of existing stone path to be crushed & reused for fill material	1220	SF	\$	\$
2.6	Earthwork & regrading of area north of boardwalk and slope failure south of path	75	CY	\$	\$
2.7	Wood boardwalk including railings stairs & sub structure	1270	SF	\$	\$
2.8	Helical piles	50	EA	\$	\$
2.9	Helical tie backs	25	EA	\$	\$
2.10	Restoration of disturbed area (boardwalk area)	1	EA	LS	\$
				Item 2 Total	\$

Park District of Highland Park
2022 Moraine Park Path Improvements

BID FORM
(Page 2 of 3)

Item No.	Item	Quantity	Unit	Unit Cost	Total
3	TABLELAND DRAINAGE				
3.1	Hand grading and installation of perforated drains	1	EA	LS	\$
3.2	Directional bore 6" HDPE storm sewer to bottom of ravine	1	EA	LS	\$
3.3	Restoration of disturbed area (tableland area)	1	EA	LS	\$
				Item 3 Total	\$
4	FILL BEHIND STEEL WALLS				
	East Steel Crib				
4.1	3'x3'x6' Gabion baskets, PVC coated with 4"-6" stone fill (double stack)	4	EA	\$	\$
4.2	Stone fill behind wall	30	CY	\$	\$
4.3	18" - 24" Boulders placed in front of Gabion baskets	21	EA	\$	\$
	West Steel Crib				
4.4	3'x3'x6' Gabion baskets, PVC coated with 4"-6" stone fill (double stack)	2	EA	\$	\$
4.5	Stone fill behind wall	40	CY	\$	\$
4.6	18" - 24" Boulders placed in front of Gabion baskets	30	EA	\$	\$
4.7	Restoration of disturbed area (east and west crib area)	1	EA	LS	\$
				Item 4 Total	\$
				TOTAL BASE BID	\$

Receipt of Addenda: The receipt of the following addenda is hereby acknowledged:

Addendum No. _____, Dated _____

Addendum No. _____, Dated _____

Addendum No. _____, Dated _____

Park District of Highland Park
2022 Moraine Park Path Improvements

BID FORM
(Page 3 of 3)

SUBCONTRACTORS: List Name, Address, Phone and Work Assignment

1. _____

2. _____


3. _____

The undersigned bidder has carefully examined the plans and specifications for the 2022 Moraine Park Path Improvements as prepared by the Owner and/or Engineer/Architect, and having carefully examined the site and completely familiarized him/herself with local conditions affecting the cost of the work: hereby states that he/she will provide all necessary labor, equipment, tools, machinery, apparatus and all other means of construction, do all the work and furnish all materials, called for by said plans and specification and drawings: and will accept as full and complete payment therefore the base bid amount which is the summation of the cost of the items of work and is equal to the summation of the extension of the unit prices.


BY: _____
Name and Title of Authorized Agent

Authorized Signature


Date

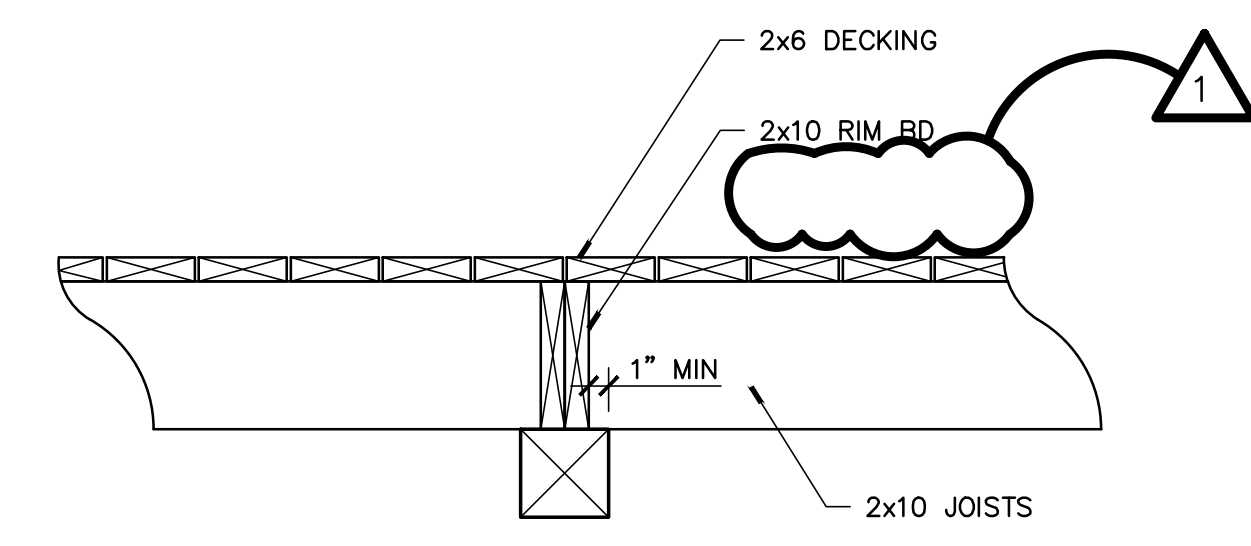


1 **DETAIL**
SCALE: 1"=1'-0"

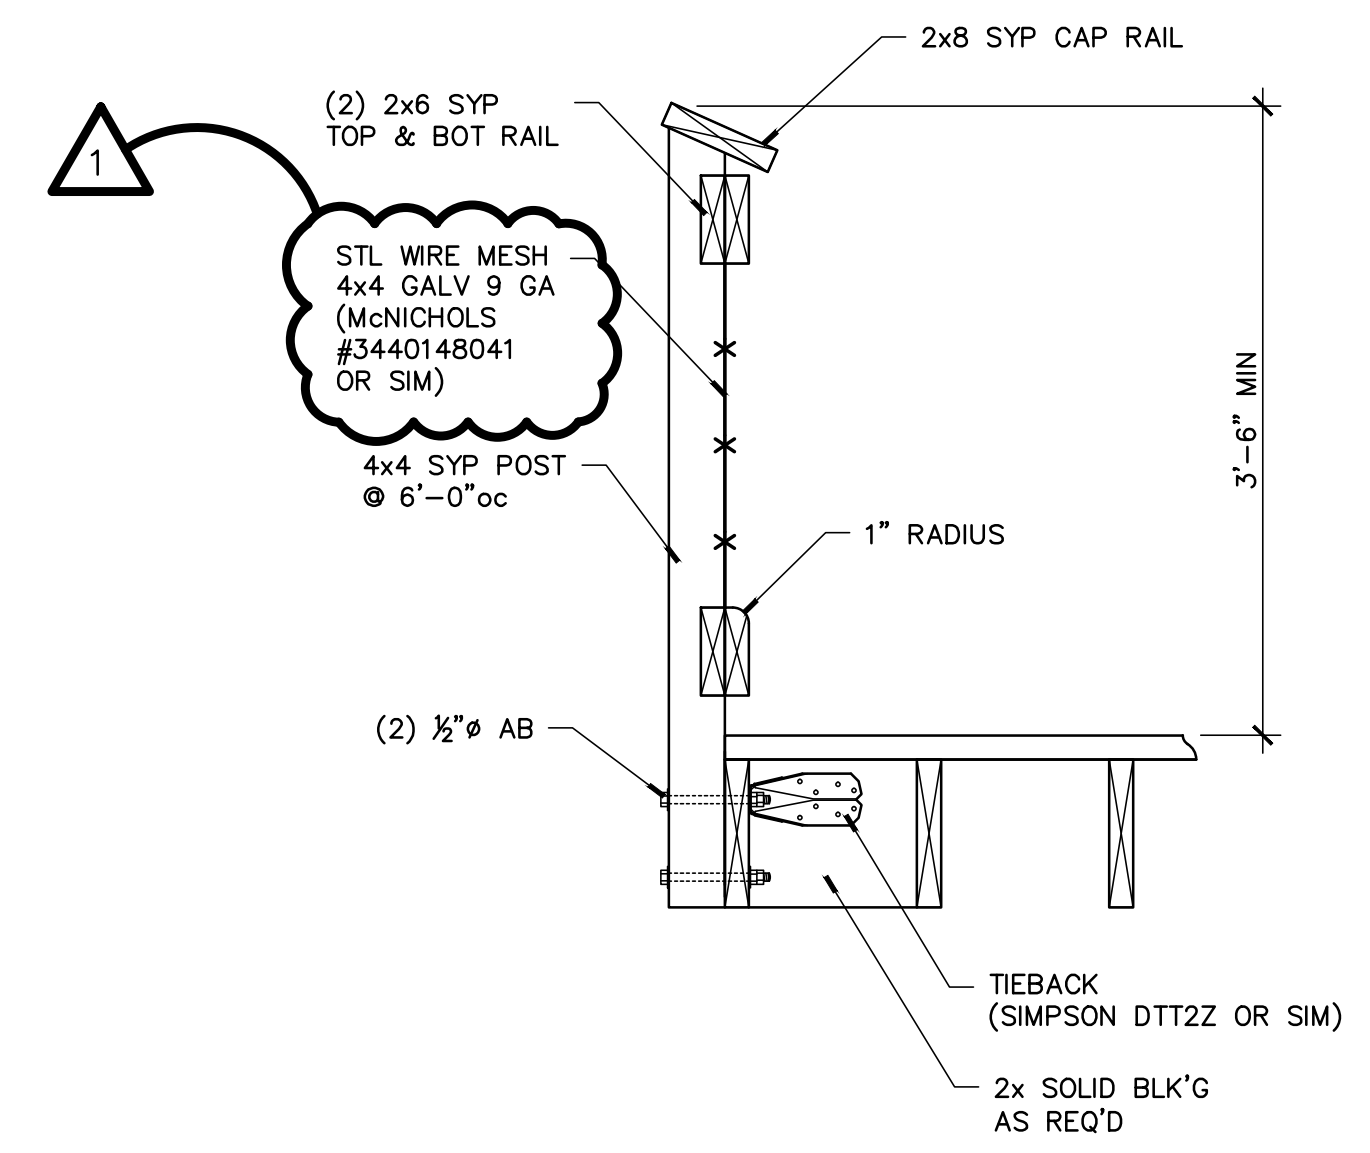


2 **DETAIL**
SCALE: 1"=1'-0"

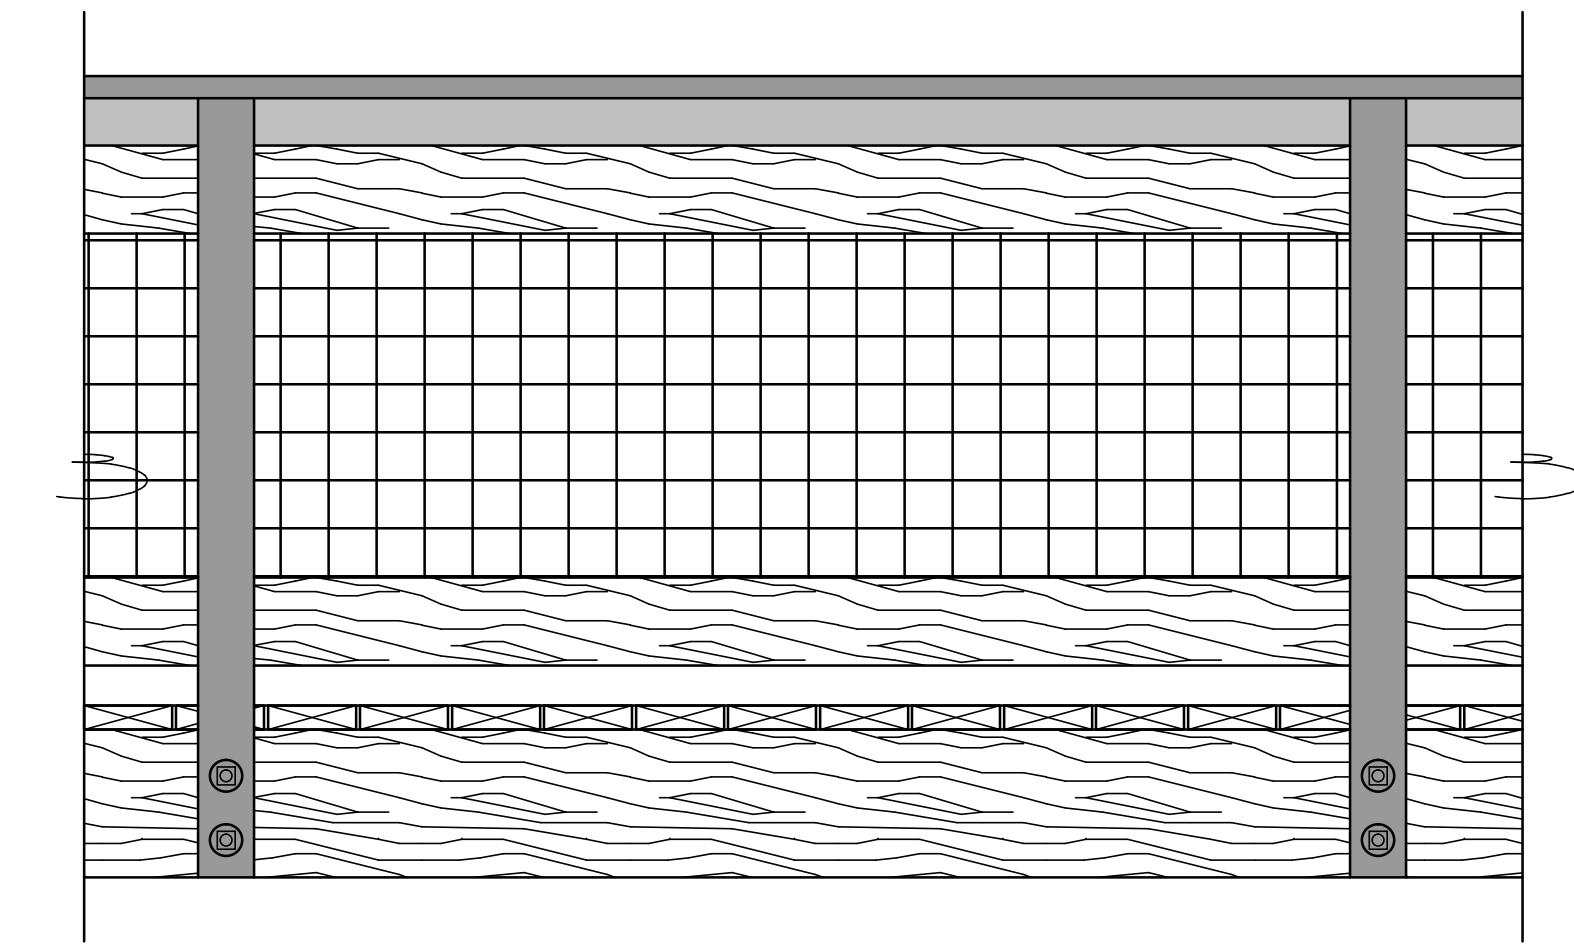


ELEVATION

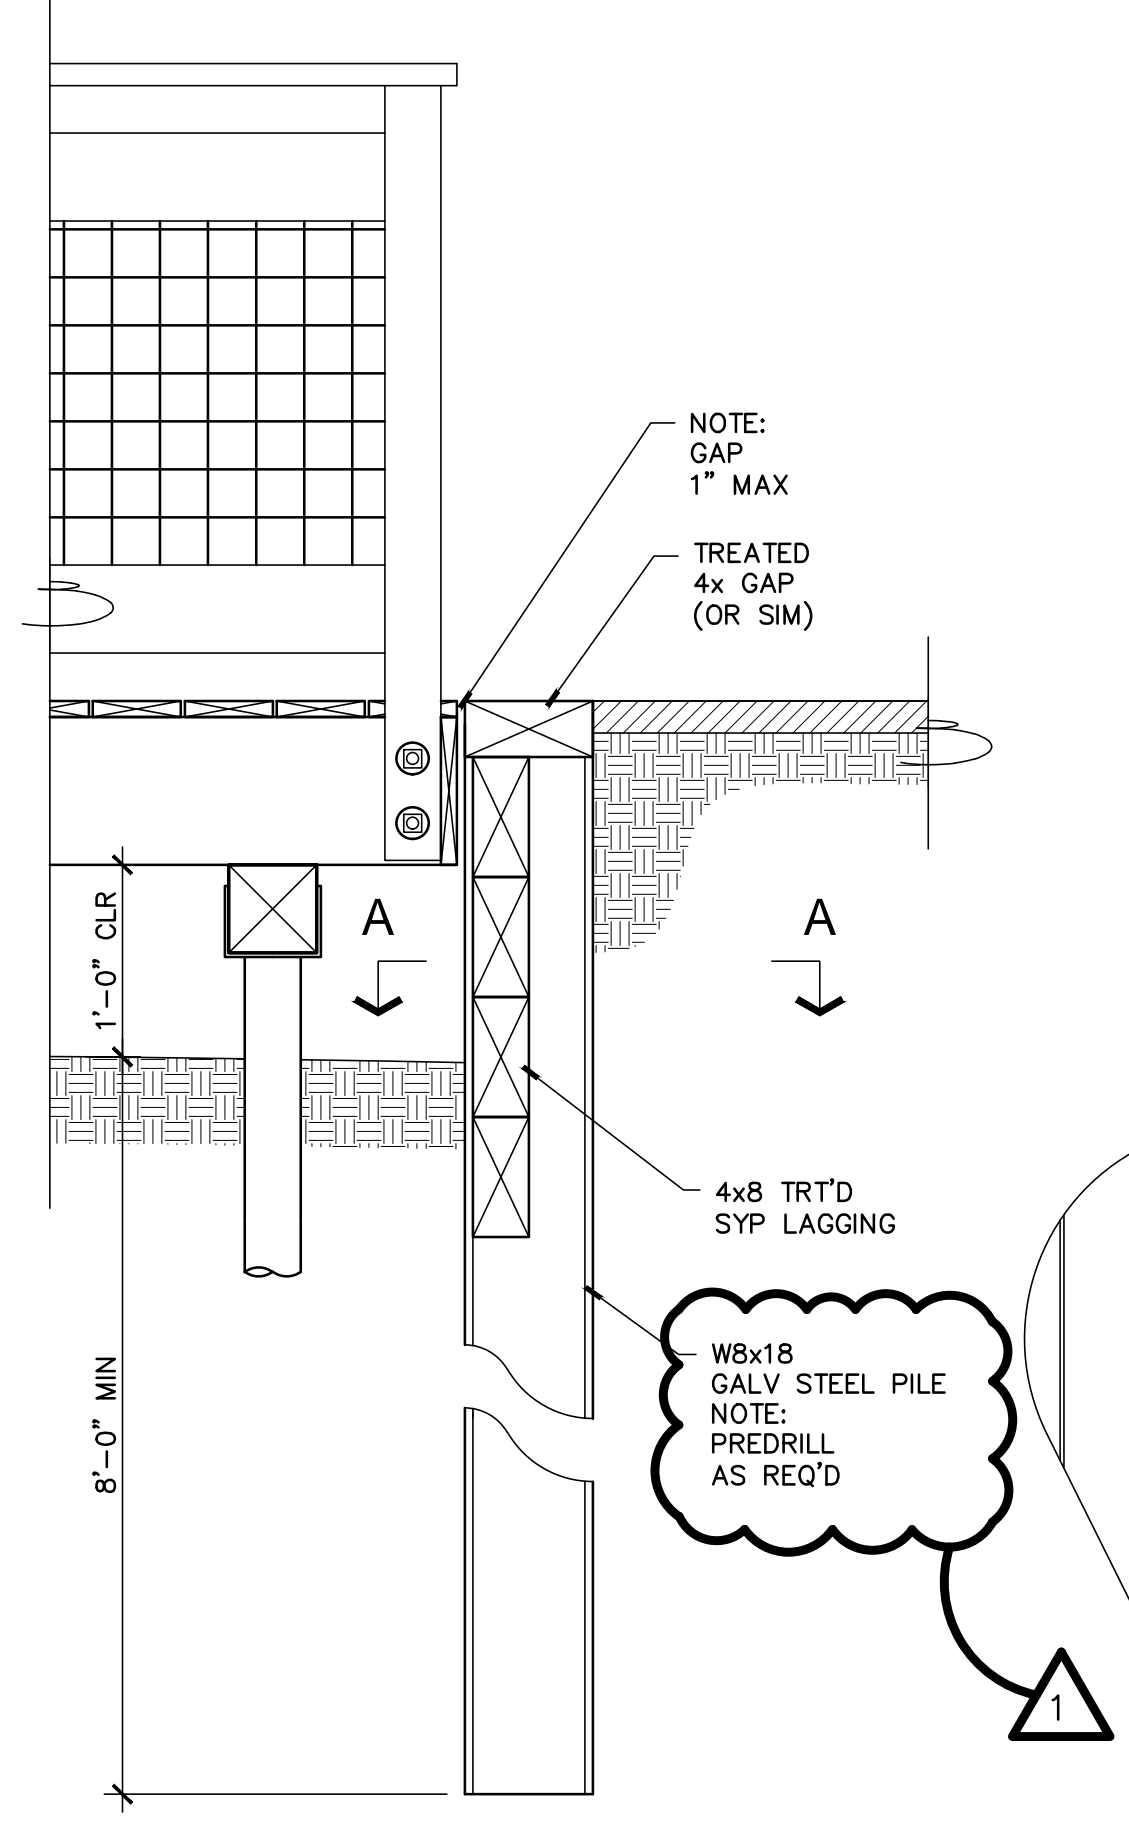

3 **DETAIL**
SCALE: 1"=1'-0"

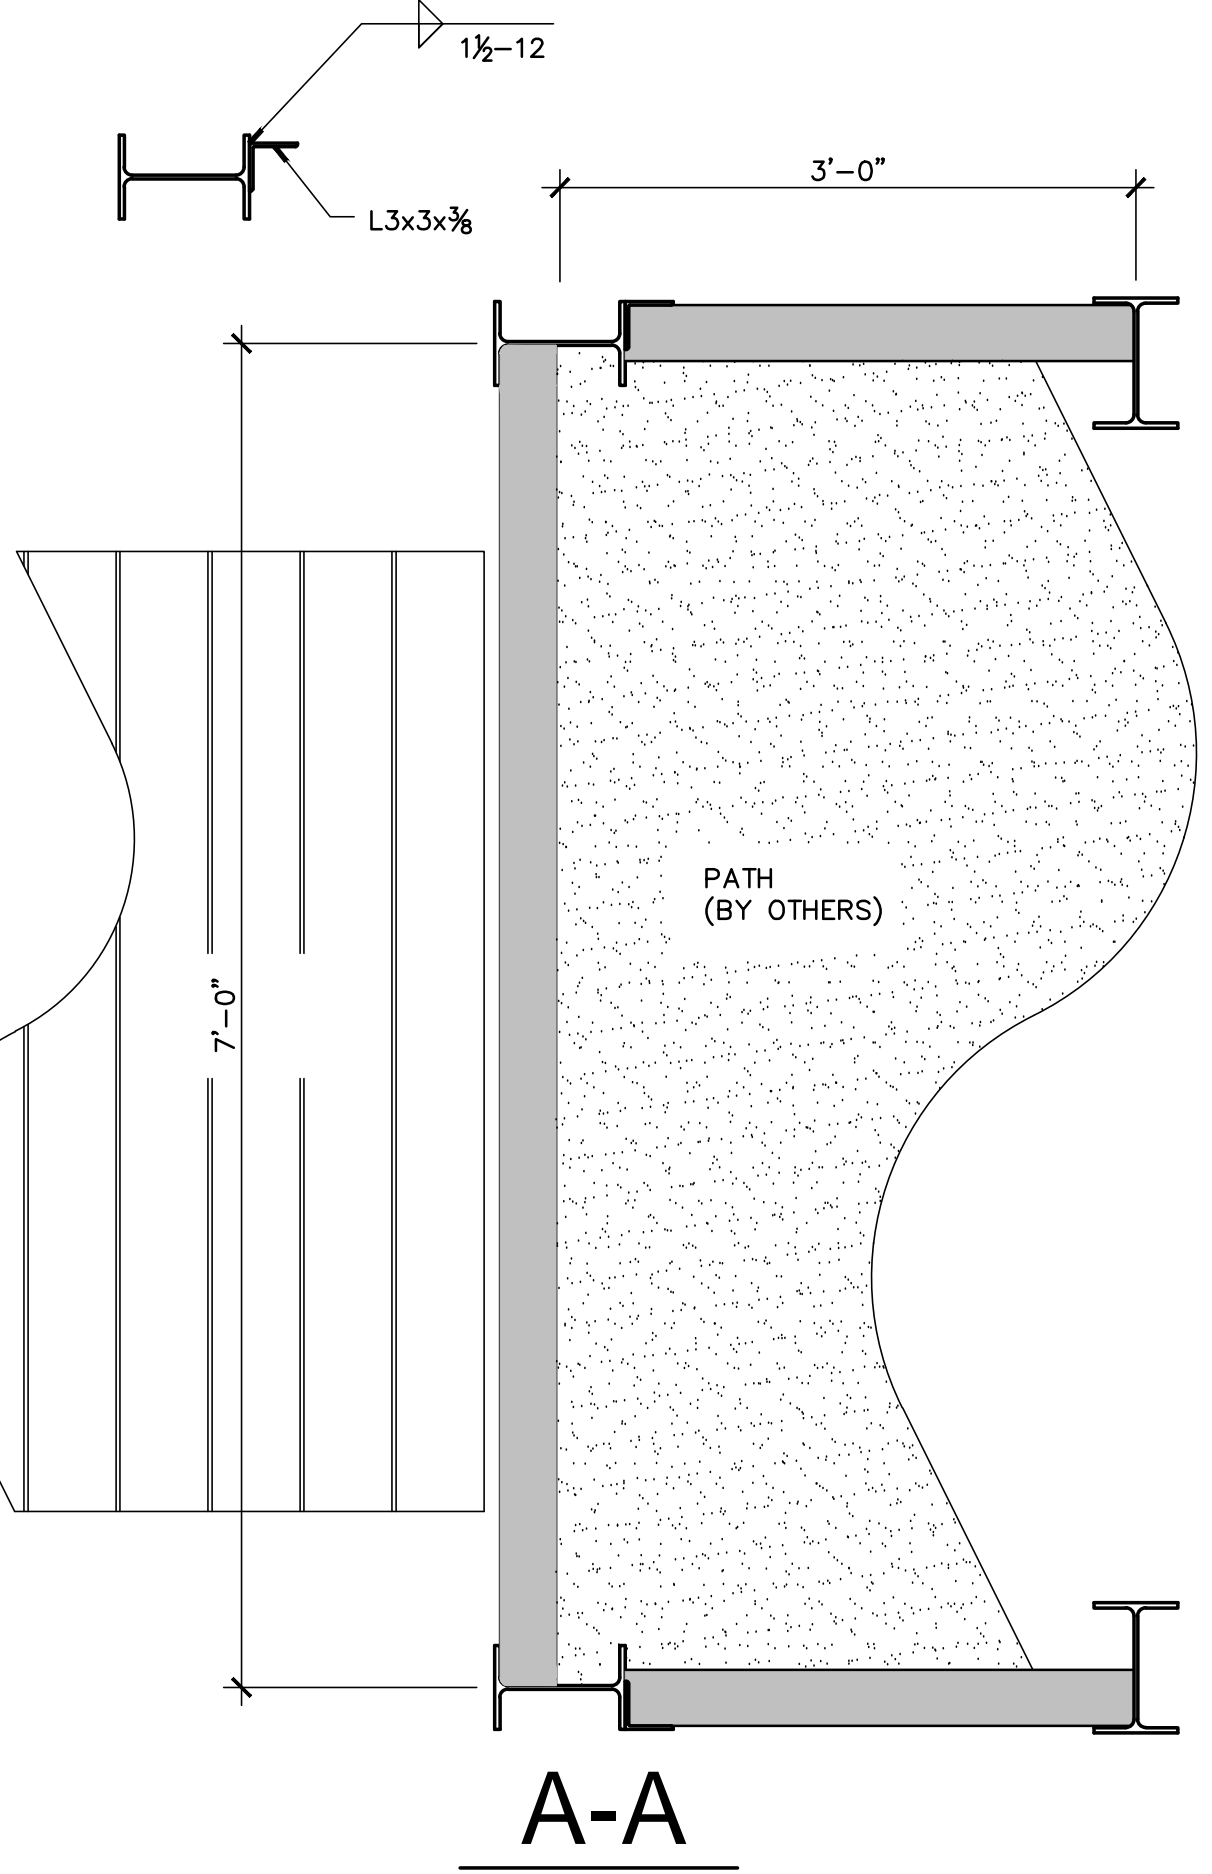


A-A

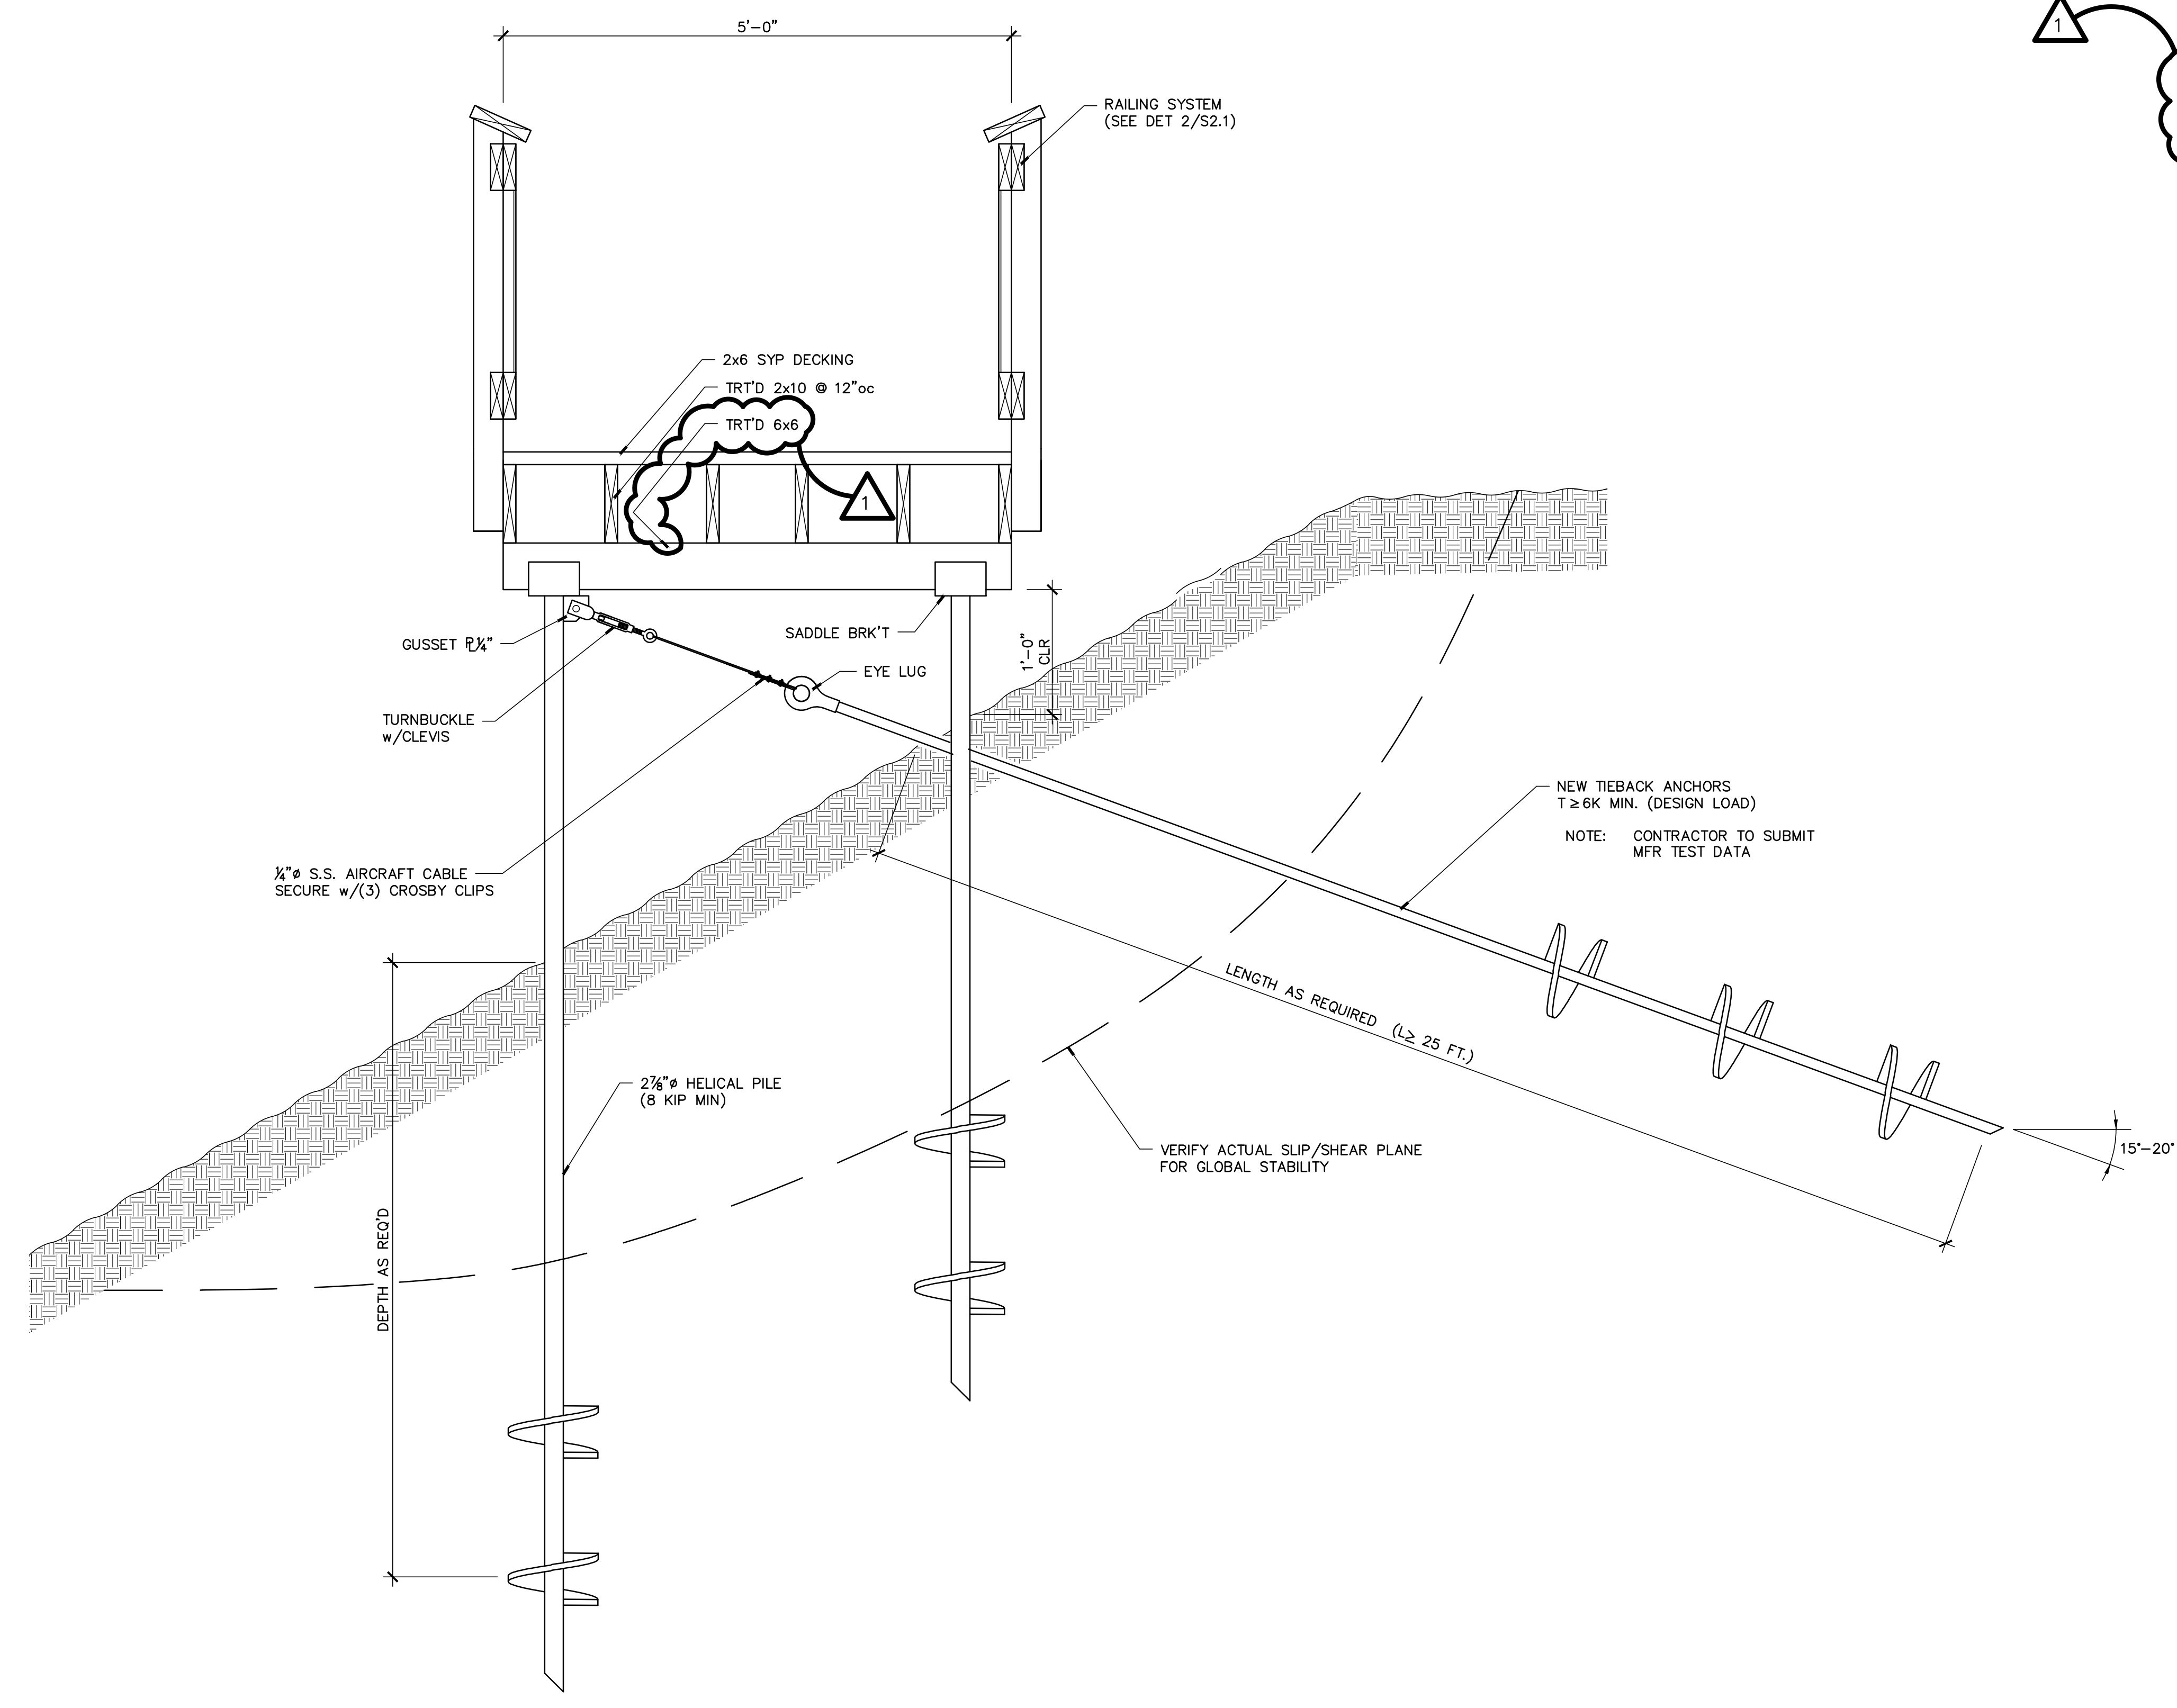

A **DETAIL**
SCALE: 1"=1'-0"

MORaine PARK PATH BOARDWALK
PARK DISTRICT OF HIGHLAND PARK
2501 SHERIDAN RD.
HIGHLAND PARK, IL

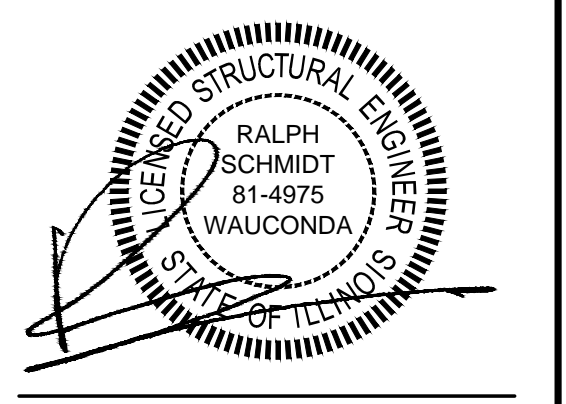

RALPH SCHMIDT, P.E., S.E.
LICENSED STRUCTURAL ENGINEER
ILLINOIS NO. 81-4875
EXP. DATE: 11-30-22

NO	DATE	ISSUED
---	10/15/21	FOR REVIEW
---	10/27/21	REV LOC. PER CIVIL
---	12/9/21	ADD DETAILS
---	1/6/22	ADD RAILINGS
---	1/31/22	FOR PERMIT AND BID
1	3/3/22	FOR ADDENDUM NO. 2

TITLE
SECTION AND DETAILS